



SOUTH EAST ELEVATION
Scale 1:100

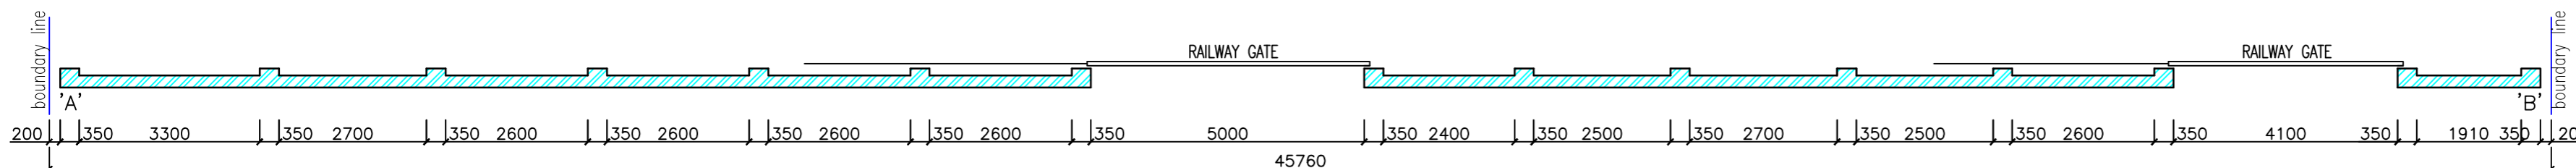

BOUNDARY WALL PLAN
SCALE 1:100

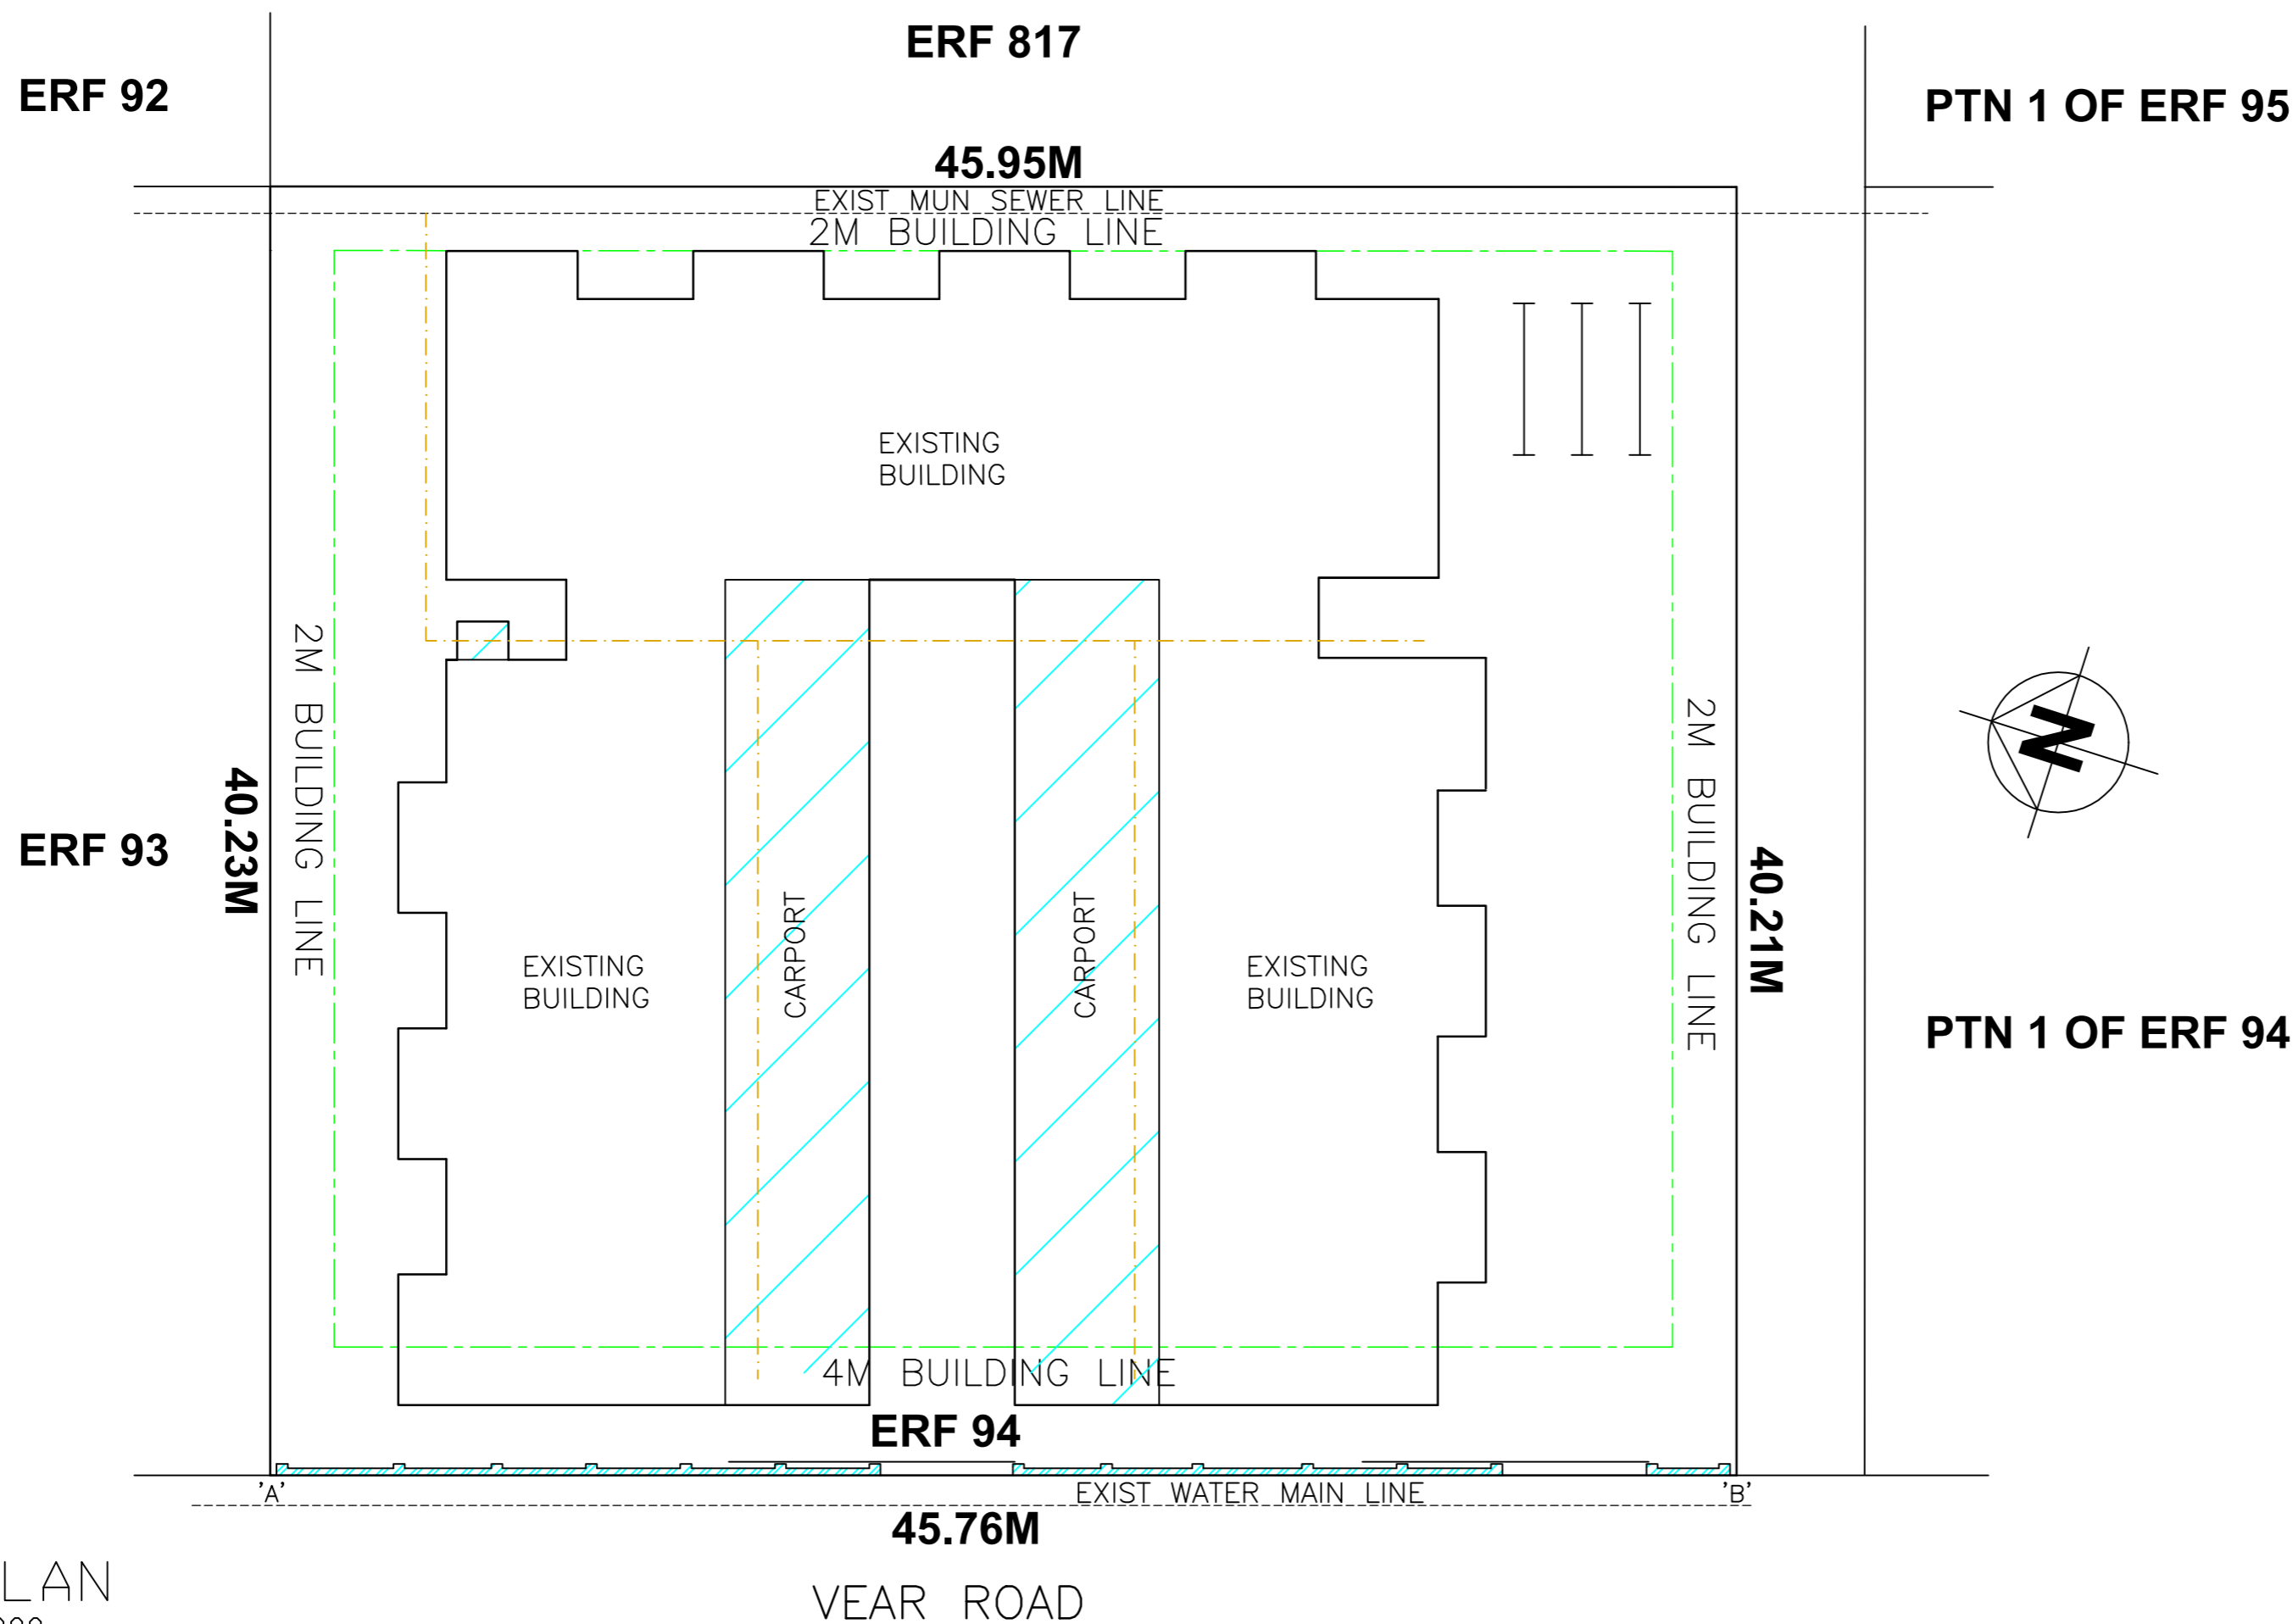

SITE PLAN
SCALE 1 : 200

COLOUR CODES

- new walls
- new asbestos
- new metal
- new conc. foundations
- new roofing
- new timber
- prop. new house on site plan

Owners signature:-

Site description:-
ERF:-94 VEAR ROAD
MERRIVALE
BOROUGH OF HOWICK
Project:-
AS-BUILT FOR JEREMIAH THULANI
NDLELA

On this drawing:-
GENERAL DRAWING

REG NO:-M06058	Date:-23-11-22
PR.ARCH.DR	
COVERAGE:-50%	Scale:-1:100
F.A.R:-0.505	1:200
DES. SIGN:-	Drawn by:-L.M
TEL:-0683057442	P.O.BOX 682
AREA PLOT:-1844.48m ²	HOWICK 3290
GROUND FLOOR:-700.9m ²	Drg. no.:-
FIRST FLOOR:-759.9m ²	sheet 5 of 5
CARPORTS:-231.8m ²	
TOTAL:-1692.3m ²	P3010